
Copyright by Expo City Dubai. All rights reserved. This document may not, in whole or in part, be reproduced, stored, transmitted or distributed ... whether electronic, mechanical, by ...rwise, without the prior written permission of ...re otherwise expressly agreed in writing by ...Dubai shall have no responsibility or liability ...ential or otherwise) which may arise from ...ument or the information contained therein.

...WING.

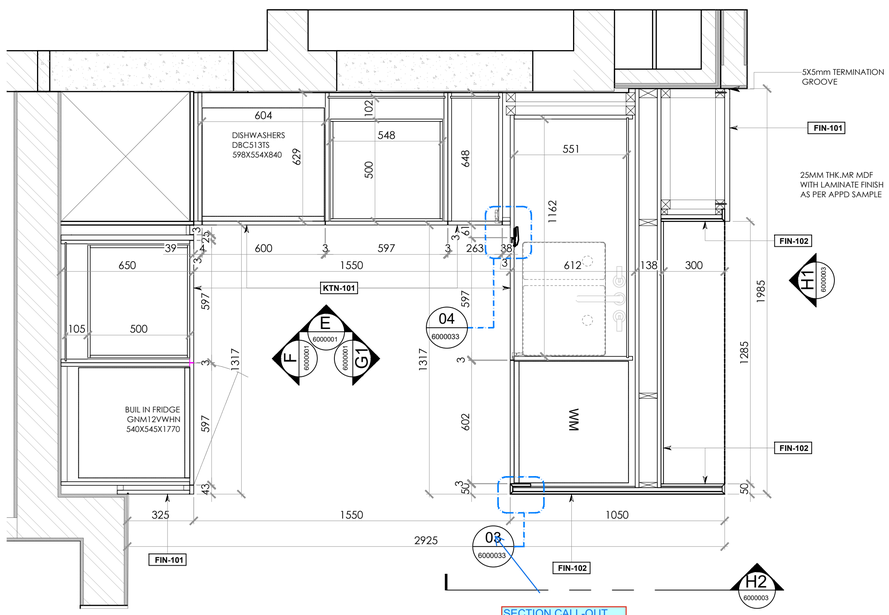


SECTION CALL-OUT INCORRECT

A 6000004 SECTION PLAN
SCALE - 1:20

MIRROR LAYOUT

ALL TO BE IN COORDINATION WITH ELEC/ WATER/ DRAINAGE PROVISIONS

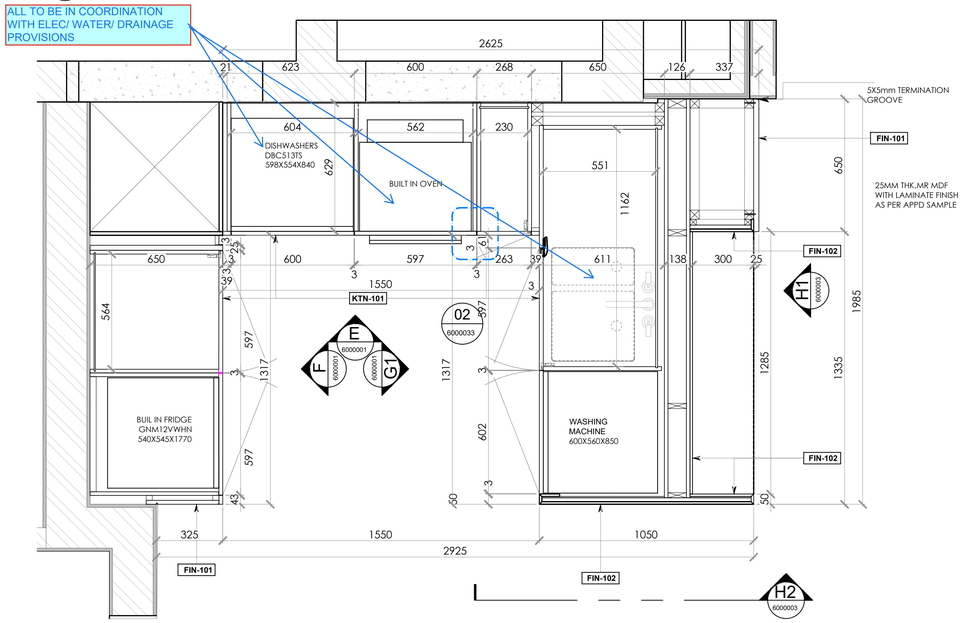

B 6000004 SECTION PLAN
SCALE - 1:20

MIRROR LAYOUT


All appliances brand shall be as per client approval and ensure all appliances are coordinated with cabinet dimensions and layout as per approved drawings.

IRONMONGERY DETAILS	
ITEM	MS REF.
HINGES	AS PER APPD.SAMPLE
DRAWER RUNNER	AS PER APPD.SAMPLE
ADJ SHELF PINS	AS PER APPD.SAMPLE
LED LIGHT	BY OTHERS

FINISH		
ITEM	CODE	MS REF.
LAMINATE	KTN-101	AS PER APPD.SAMPLE
MELAMINE	-	AS PER APPD.SAMPLE
PORCELAIN TILE	FIN-102	AS PER APPD.SAMPLE
MR MDF	-	AS PER APPD.SAMPLE
WBP PLYWOOD	-	AS PER APPD.SAMPLE
METAL TRIM	-	AS PER APPD.SAMPLE

KITCHEN EQUIPMENT		
ITEM	CODE	REF.
KITCHEN SINK	SW-101	-
SINK FAUCET	SW-106	-
DISHWASHER		DBC513TS
GAS HOB(COOK TOP)		CBEZ2411B
EXTRACTOR HOOD		WSEZ7213B1
KITCHEN FRIDGE		GNM12VWHN
KITCHEN FREEZER		GNM12VWHN
WASHER DRYER		(VB-F)

FOR TYPICAL SECTION & DETAIL'S PLEASE REFER DWG NO- C5128-SDW-2TR5600-FO-6000133, C5128-SDW-2TR5600-FO-6000134, C5128-SDW-2TR5600-FO-3000005, C5128-SDW-2TR5600-FO-6000036 C5128-SDW-2TR5600-FO-6000001 C5128-SDW-2TR5600-FO-6000003

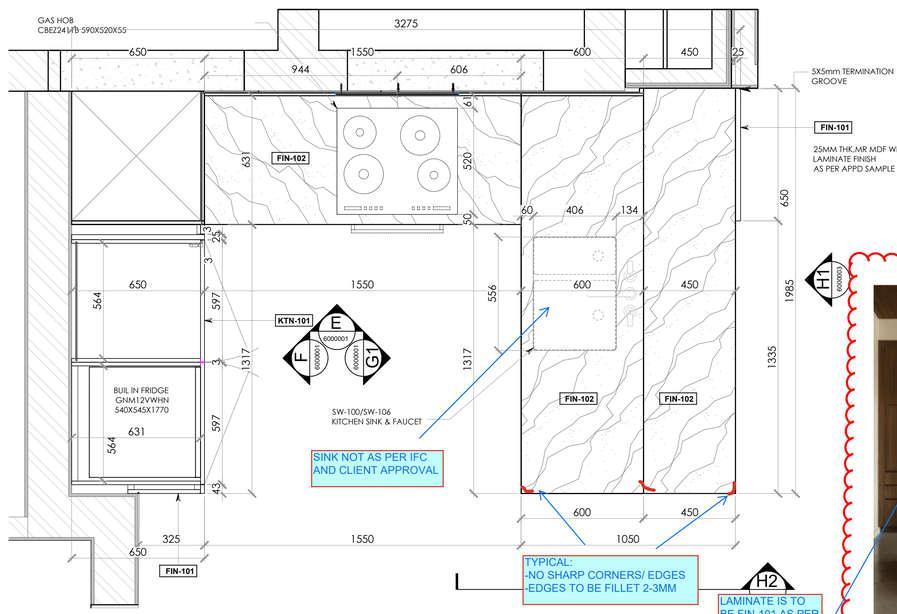

TYPICAL:
-NO SHARP CORNERS/ EDGES
-EDGES TO BE FILLET 2-3MM

LAMINATE IS TO BE FIN-101 AS PER SPEC'S, PROJ. REPORT (C3079-RPT-2TR5600-AR-0000006(A)), & IFC DRAWINGS

C 6000004 SECTION PLAN
SCALE - 1:20

MIRROR LAYOUT

D 6000004 SECTION PLAN
SCALE - 1:20

MIRROR LAYOUT

-6MM BACK PANEL NOT ACCEPTABLE

-9MM TO BE PROPOSED SIMILAR TO WARDROBES APPROVED VE APPENDIX 2

-SUBJECT TO COST SAVING

***BASE CABINET* -KTN-101**

INTERNAL CARCASE -18mm THK MELAMINE MR MDF CABINET WITH PVC LIPPING.

SHUTTER - 18mm THK MR MDF WITH (FIN-01) LAMINATE FINISH WITH PVC LIPPING.

BACK PANEL -6MM THK MELAMINE MR MDF.

SKIRTING
18mm THK MR MDF WITH (FIN-01) LAMINATE FINISH.

***WALL CABINET* -KTN-101**
CARCASE-18mm THK MELAMINE MR MDF CABINET WITH PVC LIPPING.

SHUTTER- 18mm THK MR MDF WITH (FIN-01) LAMINATE FINISH WITH PVC LIPPING.

SHELF -18mm THK MELAMINE MDF WITH PVC LIPPING ALL AROUND TO MATCH MELAMINE.

BACK PANEL -6 MM THK MELAMINE MDF.

***COUNTER TOP* & SPLASH BACK**

12 MM THK PORCELAIN TILE GLUE FIXING (FIN-102)TYPICAL.

BACK SPLASH ON GAS HOB LOCATION (LIN-201)

FULL HEIGHT SIDE & TOP LENGTH PANEL

25 MM MR MDF WITH LAMINATE (FIN-01) WITH PVC LIPPING
ALL INFILL MATCH TO LAMINATE (FIN-01)


ALL FINISHES ARE AS PER LORJ APPROVED SAMPLE.

CABINET HARDWARE AS PER LORJ APPROVED SAMPLE.

DAE:
1. Comply with IFC drawing, spec's., schedules, and to be in full coordination with MEP IFC and MEP shop drawing approvals, and relevant RFI's
2. Conduct field measurement prior to any fabrication or installation at site.
3. Materials to be in accordance with project spec's., approved samples by client, approved material technical submittals.
4. Provide detailed edge profiles for exposed elements
5. Submit relevant prequalification of specialist subcontractor for seperate review/ approval's
6. To be in conjunction with any relevant RFI's. If any relevant RFI are to be responded after this SD approval, SD are to be updated accordingly and re-submit
7. To stricty comply with DM Al Sa'fat regulation and any other pertinent authority standards
8. Kitchen joinery are to precisely fit, workable and have exact cut outs as per the approved white goods



6. KITCHEN UNITS (FIN-101) & COUNTER (FIN-102)
High Pressure Laminate unit fascias (NewMike, 'Sumac Oak') with porcelain tile counter-tops (Marmeria Italiana, 'Lincoln Durato').

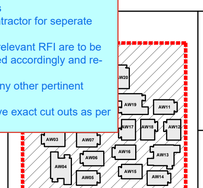

Master Plan



North Arrow



General Notes

Dewan Architects+ Engineers
REVIEW NOTE
- Code A - Approved
- Code B - Approved As Noted, Resubmit
- Code C - Not Approved, Resubmit
- Code D - Information, Record
- Code E - Incomplete, Resubmit

Approved / Approved As Noted does not relieve the Contractor / Supplier from full compliance with his contractual obligation

REFERENCE-IFC	
01	GA Plan - Ground Level -C3079-DWG-2TR5600-AR-2GF2106(A)
02	KITCHEN TYPE - LOFT -C3079-DWG-2TR5600-AR-5002501
03	Kitchen Details-C3079-DWG-2TR5600-AR-6002501
04	Kitchen Details-C3079-C3079-DWG-2TR5600-AR-6002502

No	Description

SAFETY, HEALTH AND ENVIRONMENT INFORMATION
Brief details on the identified hazard symbol referencing the unusual residual hazards / risks are listed above.

SHOP DRAWING

Rev	Description	Drawn	Apvr	Chk'd	Date
1	FIRST ISSUE	JD	KABILAN	RAJA	21-03-2026

Client
مدينة إكسبو دبي
EXPO CITY DUBAI

Design Consultant
HOPKINS ARCHITECTS

Supervision Consultant
Dewan Architects + Engineers

Main Contractor
ARCO GROUP
P.O.Box: 5430 I Dubai, United Arab Emirates I Tel: +971 4 2677603 I Fax: +971 4 2677604
E-mail: info@arcogroup.org I Website: www.arcogroup.org

Project Title
AL WAHA RESIDENCE 01
EXPO CITY DUBAI

Drawing Title
PHASE-01 - MOBILITY DISTRICT
TYPICAL KITCHEN - DETAIL (TYPE- C1)
KITCHEN SECTIONAL PLAN
(SHEET- 3 OF 3)

Approved		Seal Date
KABILAN		21-03-2026
Designed	Drawn	Checked
DESIGNED BY	JD	RAJA
Model File Ref:	Scale A1(594x841)	Revision No
KITCHEN	AS SHOWN	1

Drawing No
C5128-SDW-2TR5600-FO-6000004

Building Number	Level	Apart. Number	Kitchen Orientation	Kitchen shape	Kitchen type	Kitchen Qty
AW1	2ND	201	MIRROR	U-SHAPE	C1	1
AW6	2ND	201	MIRROR	U-SHAPE	C1	1
AW8	2ND	201	MIRROR	U-SHAPE	C1	1
AW8	2ND	202	MIRROR	U-SHAPE	C1	1
AW9	1ST	102	MIRROR	U-SHAPE	C1	1
AW9	1ST	105	MIRROR	U-SHAPE	C1	1
AW9	2ND	202	MIRROR	U-SHAPE	C1	1
AW9	2ND	205	MIRROR	U-SHAPE	C1	1
AW17	2ND	201	MIRROR	U-SHAPE	C1	1
AW18	2ND	201	MIRROR	U-SHAPE	C1	1
AW19	1ST	102	MIRROR	U-SHAPE	C1	1
AW19	1ST	105	MIRROR	U-SHAPE	C1	1
AW19	2ND	202	MIRROR	U-SHAPE	C1	1
AW19	2ND	205	MIRROR	U-SHAPE	C1	1
AW21	1ST	102	MIRROR	U-SHAPE	C1	1
AW21	1ST	104	MIRROR	U-SHAPE	C1	1
AW21	1ST	107	MIRROR	U-SHAPE	C1	1
AW21	1ST	112	MIRROR	U-SHAPE	C1	1
AW21	1ST	114	MIRROR	U-SHAPE	C1	1
AW21	2ND	202	MIRROR	U-SHAPE	C1	1
AW21	2ND	204	MIRROR	U-SHAPE	C1	1
AW21	2ND	207	MIRROR	U-SHAPE	C1	1
AW21	2ND	212	MIRROR	U-SHAPE	C1	1
AW21	2ND	214	MIRROR	U-SHAPE	C1	1
AW21	3RD	302	MIRROR	U-SHAPE	C1	1
AW21	3RD	304	MIRROR	U-SHAPE	C1	1
AW21	3RD	307	MIRROR	U-SHAPE	C1	1
AW21	3RD	312	MIRROR	U-SHAPE	C1	1
AW21	3RD	314	MIRROR	U-SHAPE	C1	1